



APPROXIMATE EXCAVATION DEPTH AND MANAGEMENT

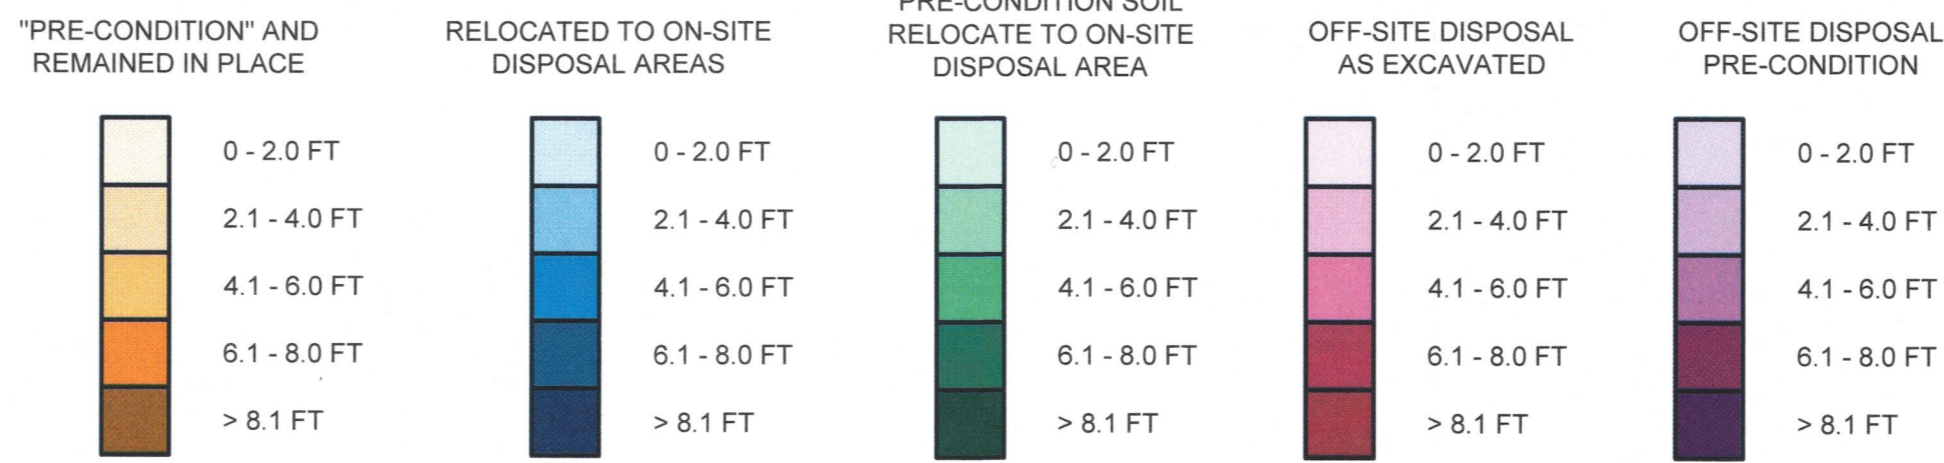

LEGEND

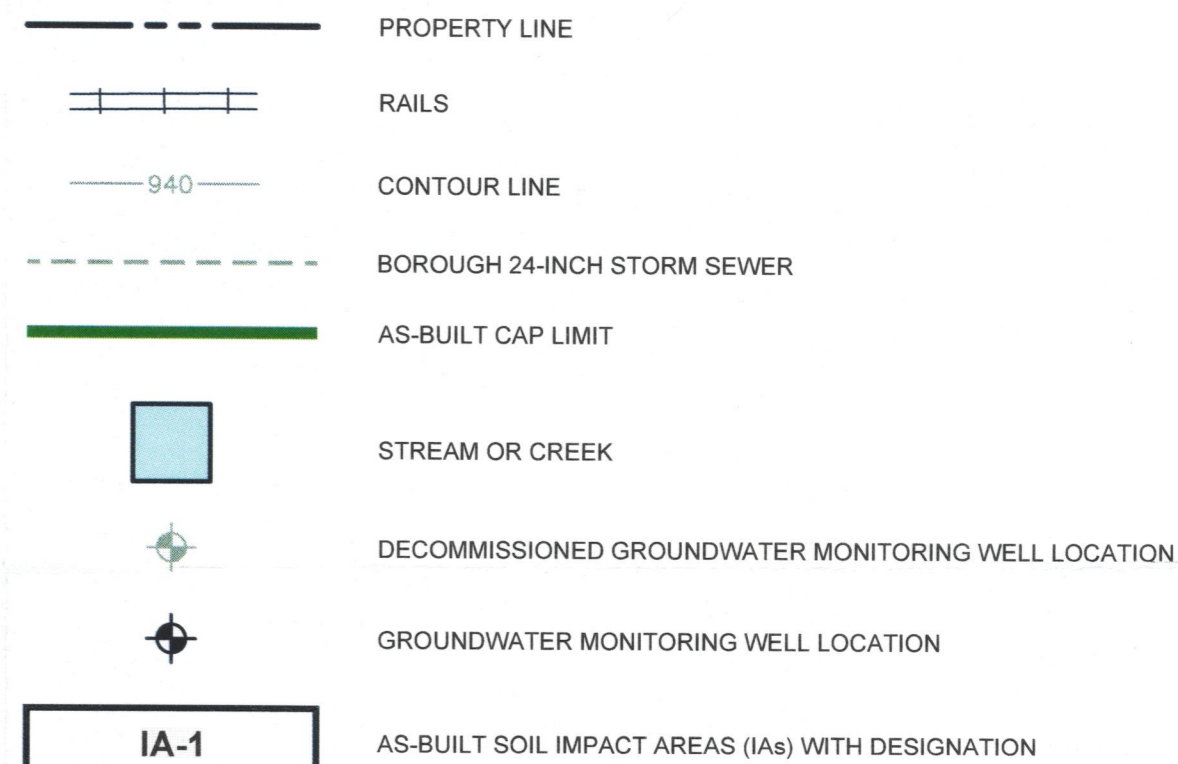

REFERENCES

- 1.) BASE MAP COMPILED FROM DIGITAL CAD FILES 08-3820 GOLDER-N-S.dwg, TITLED "TOPOGRAPHIC SURVEY OF TRINITY INDUSTRIES, INC.," PROVIDED BY HOWELLS & BAIRD, INC. DATED JUNE 25, 2008 (REVISED JULY 15, 2009) AND 11-4417 A.dwg AND 11-4417 B.dwg, TITLED "TOPOGRAPHIC SURVEY FOR TRINITY INDUSTRIES, INC. - SOUTH PLANT," PROVIDED BY HOWELLS & BAIRD, INC. DATED JULY 2011.
- 2.) THE HORIZONTAL COORDINATES SHOWN HEREON ARE REFERENCED TO PENN DOT MONUMENTS AO-86 AND AO-85 (PENNSYLVANIA STATE PLANE COORDINATE SYSTEM - NAD83)
- 3.) LOCATION OF BOROUGH 24-INCH STORM SEWER FROM CHICAGO BRIDGE AND IRON COMPANY DRAWING TITLED "FLOOD CONTROL PLAN IN VICINITY OF C.B. & I CO. PLANT," DATED APRIL 22, 1974.
- 4.) PRE-DESIGN AND ADDITIONAL INVESTIGATION LOCATIONS WERE TAKEN FROM DIGITAL CAD FILE "08-3820 GOLDER-N-S 9-6-12," PROVIDED BY HOWELLS & BAIRD, INC. DATED SEPTEMBER 6, 2012.
- 5.) IMPACTED AREAS COMPILED FROM DIGITAL CAD FILES "IA ASBUILT 8-8-14.DWG," "IA ASBUILT 8-14-14.DWG," "14-4923 GOLDER-S 8-21-14.DWG," "14-4923 GOLDER-S 8-28-14.DWG," "9-17-14-14-4923 GOLDER S.DWG," "TESTS 10-30-14 TRINITY S.DWG" AND "TESTS 11-24-14 TRINITY S.DWG," PROVIDED BY HOWELLS & BAIRD, INC.
- 6.) CAP LIMIT TAKEN FROM DIGITAL CAD FILE 14-4923 LINER AS-BUILT 10-10-14.DWG, TITLED "DISPOSAL AREA LINER AS-BUILT," PREPARED BY HOWELLS & BAIRD, INC. DATED SEPTEMBER 29, 2014.



REV	DATE	DES	REVISION DESCRIPTION	CADD	CHK	RVW
PROJECT CONSTRUCTION DOCUMENTATION REPORT - SOUTH PLANT TRINITY INDUSTRIES, INC. GREENVILLE, PA						
TITLE SOIL RESPONSE ACTIONS AND EXTENT OF EXCAVATIONS						
PROJECT No. 073-6009 FILE No. 0736009AX01						
DESIGN	BJG	05/22/17	SCALE	AS SHOWN	REV.	0
CADD	RG	05/22/17	ATTACHMENT C DRAWING 1			
CHECK	BJG	05/22/17				
REVIEW	JBG	05/22/17				

